

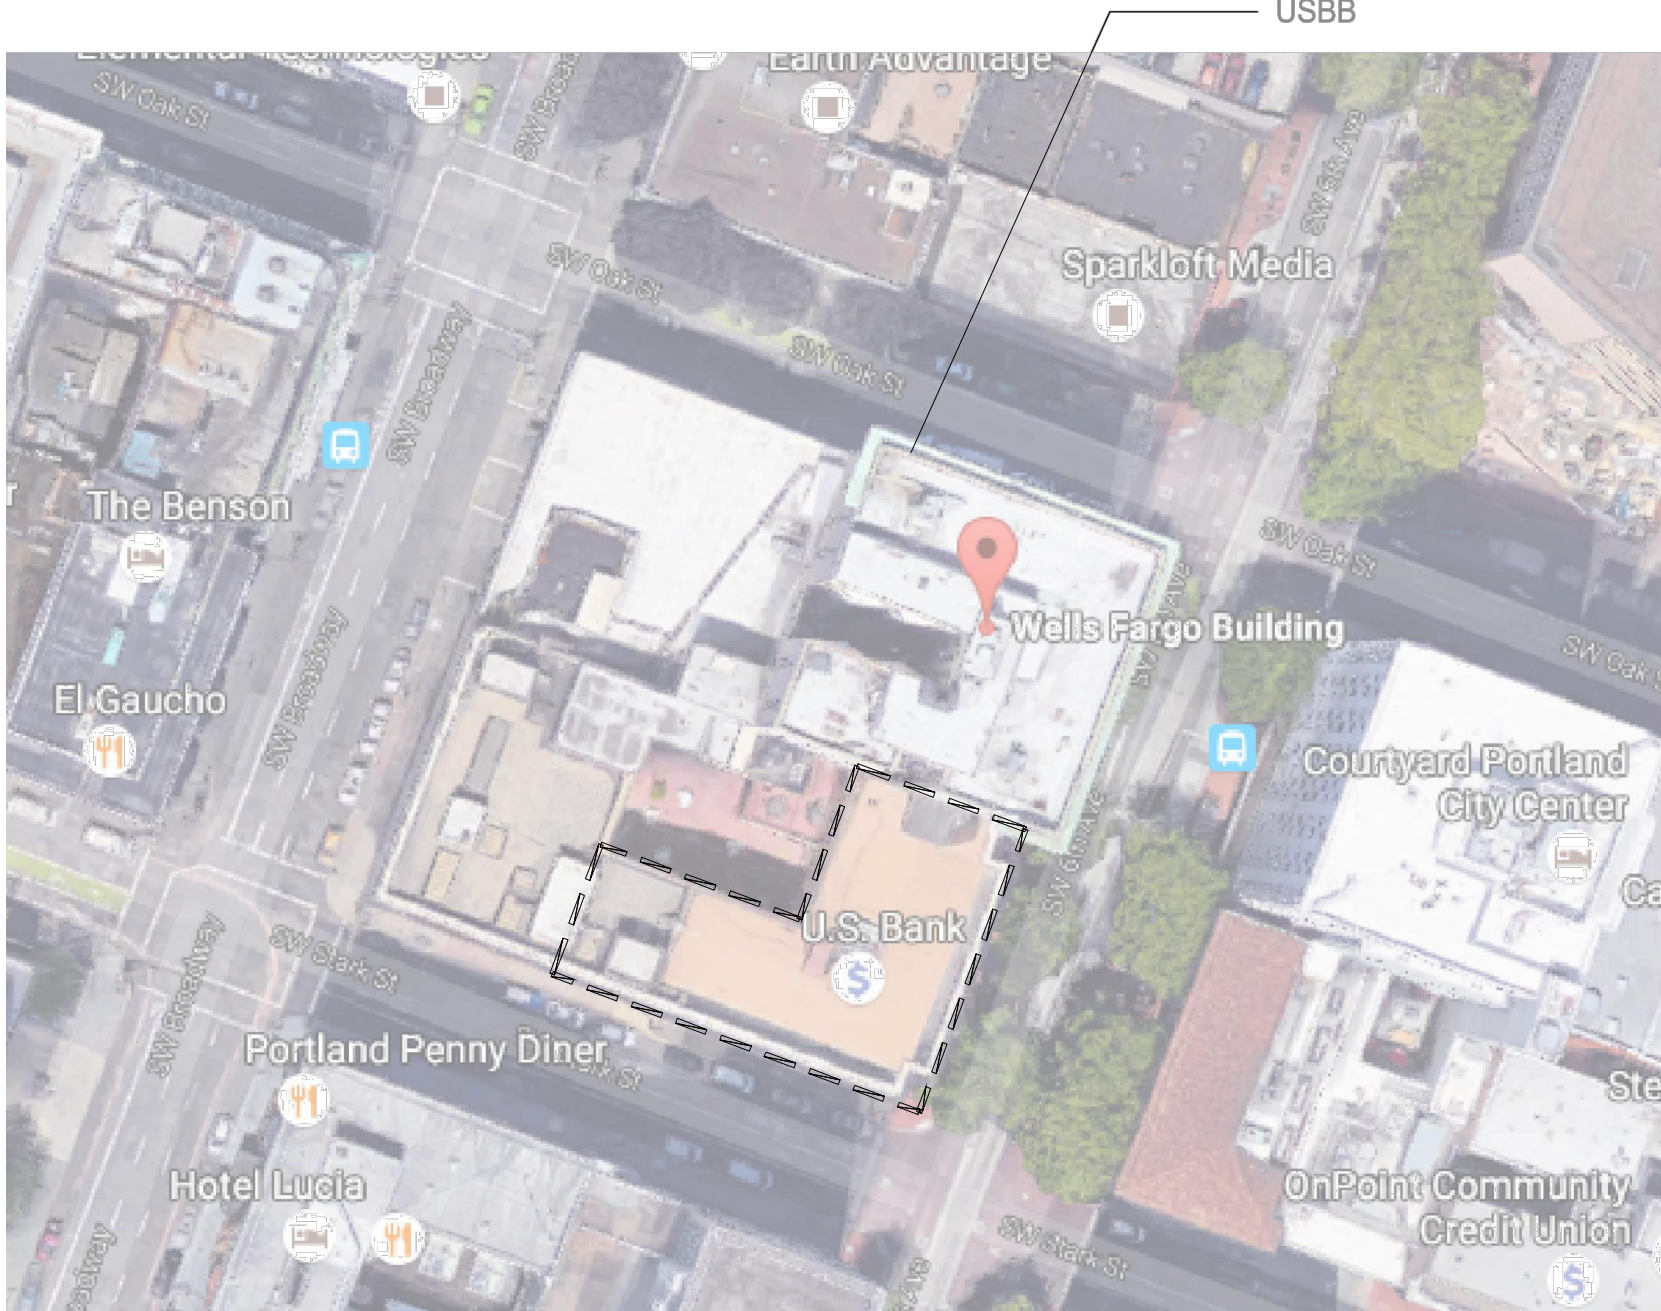
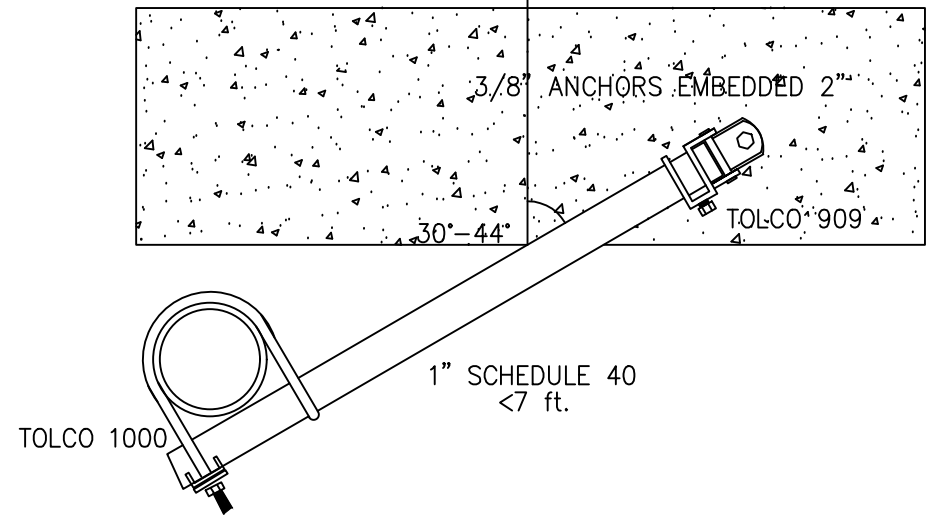


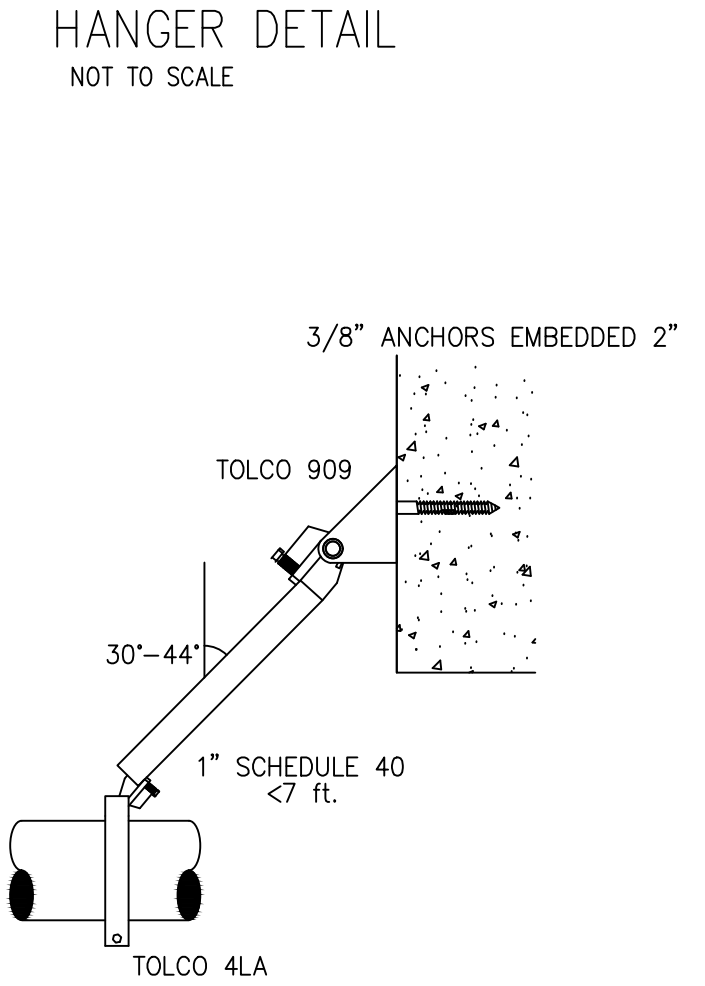

AS BUILT

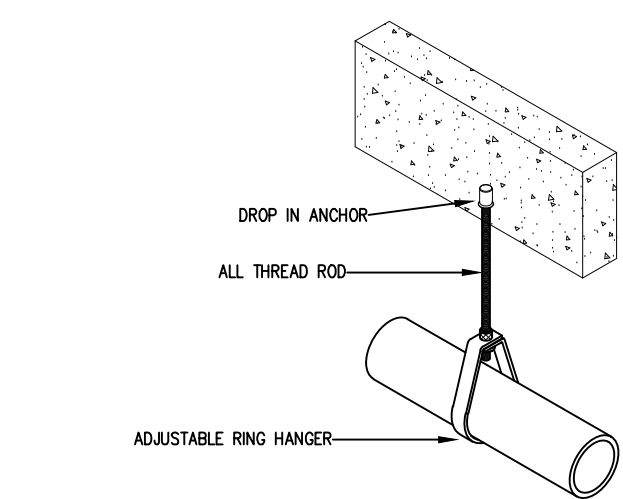

NOTES											
Meets design requirements of NFPA 13 2013 edition.											
All new piping to be Eddy Thread Schedule 40 w/ screwed ductile iron fittings.											
All hangers to be per NFPA 13 requirements.											
All armovers greater than 2'-0" shall be provided with hangers.											
Area of work to be protected as a light hazard occupancy.											
Max. sprinkler spacing to be 225 sq. ft. per head.											
SPRINKLER SYMBOLS											
SYMBOL	STATUS	BRAND	SIN	TYPE	FINISH	TEMP (°F)	ORIFICE	THREAD	K <sub>t</sub> FACTOR	NOTES	TOT.
	NEW	TYCO	TY323	SSP-OR	Ch/Ch	155	1/2"	1/2"	5.6		4
	NEW	TYCO	TY313	SSU-OR	Br	155	1/2"	1/2"	5.6		57